

BASE PLAN INFORMATION:
RECORD INFORMATION TAKEN FROM A PLAN ENTITLED:
"FINAL MAJOR SUBDIVISION PLAN (SHEETS 1-7)"
REGENCY @ PROVIDENCE (A.K.A. FOGEL TRACT)
PREPARED BY EASTERN STATES ENGINEERING DATED: 12/08/03 LAST REVISED: 01/28/05 GRADING INFORMATION TAKEN FROM A PLAN ENTITLED: "GRADING AND UTILITY PLANS"
PREPARED BY: EASTERN STATES ENGINEERING DATED: 12/08/03 LAST REVISED: 01/31/05 NOTE:
LOCATION OF UTILITY SERVICES SHOWN ARE
CONCEPTUAL ONLY. ACTUAL LOCATION OF
SANITARY, WATER, ELECTRIC, GAS, ETC. SERVICING
EACH LOT TO BE DETERMINED AT TIME OF
CONSTRUCTION BY DEVELOPER CONSTRUCTION BY DEVELOPER. BUILDING SETBACK INFORMATION: FRONT YARD SETBACK 20' SIDE YARD SETBACK 5'

REAR YARD SETBACK 15'

PROPOSED ELEVATIONS
ARROWS INDICATE REQUIRED GRADING FOR SURFACE DRAINAGE FLOW

EXISTING CONTOURS


INDICATES CONCRETE MONUMENT TO BE SET

---- BASEMENT DIG LINES

PROPOSED HOUSE: WALDEN FEDERAL

14" J.S.I. FLOOR SYSTEM 2 CAR (FE) GARAGE EXPANDED FAMILY ROOM W/BASEMENT (023)(049)
STANDARD BASEMENT W/OPTIONS (016) STANDARD 8' HEIGHT FOUNDATION

151 Sloan Rd.

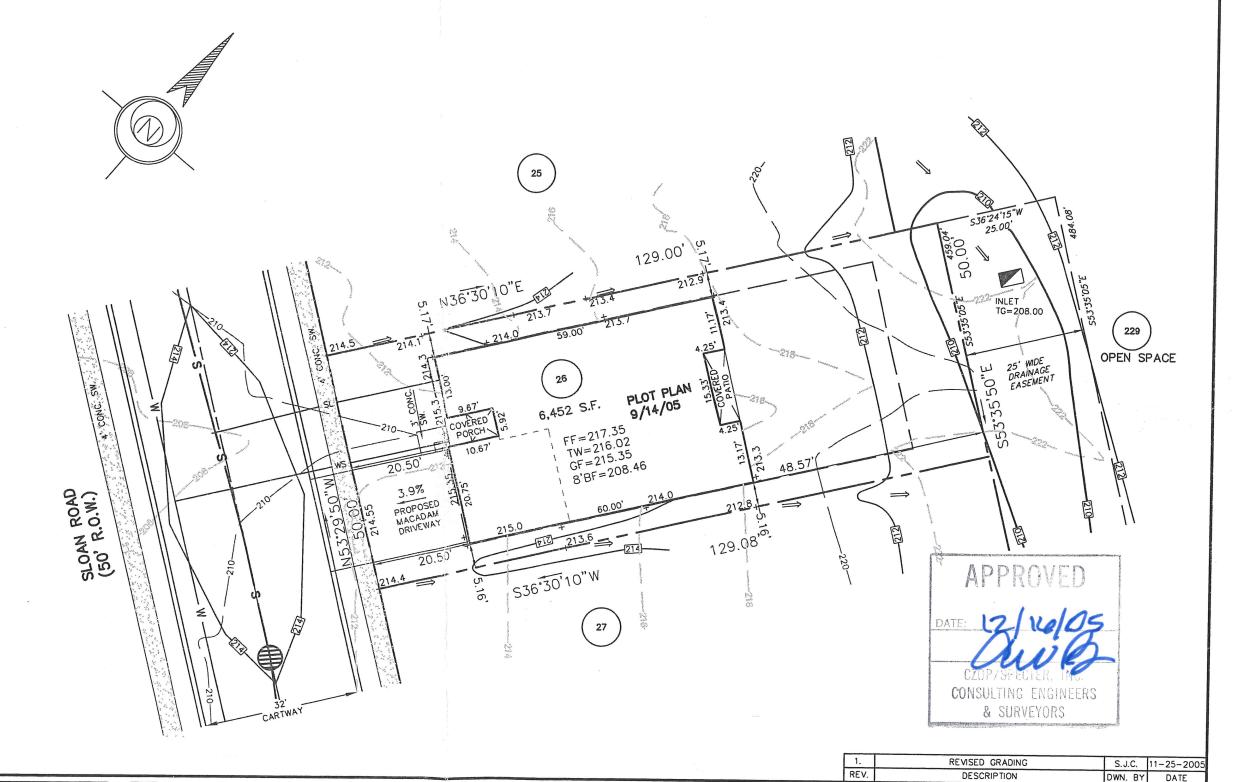

E S E EASTERN STATES **ENGINEERING** 

250 GIBRALTAR ROAD 2nd FLOOR, EAST WING HORSHAM, PA. 19044 TEL: (215) 914-2050 FAX: (215) 293-5489

THOMAS B. HENDRICKS PROFESSIONAL LAND SURVEYOR PA LICENSE NO. SU-044552 PA LOT

26

"PLOT PLAN"

REGENCY @ PROVIDENCE

UPPER PROVIDENCE TOWNSHIP

9-14-2005

JOB NO .: 1114

FILE NAME: LOT026-1114

ORDER NO.:

PP111400260001

DRAWN: M.P.G.


1"=20'


SCALE:


SHEET NO.: OF

CIVIL ENGINEERS - LAND SURVEYORS - LANDSCAPE ARCHITECTS - LAND PLANNERS

MONTGOMERY COUNTY, PENNSYLVANIA

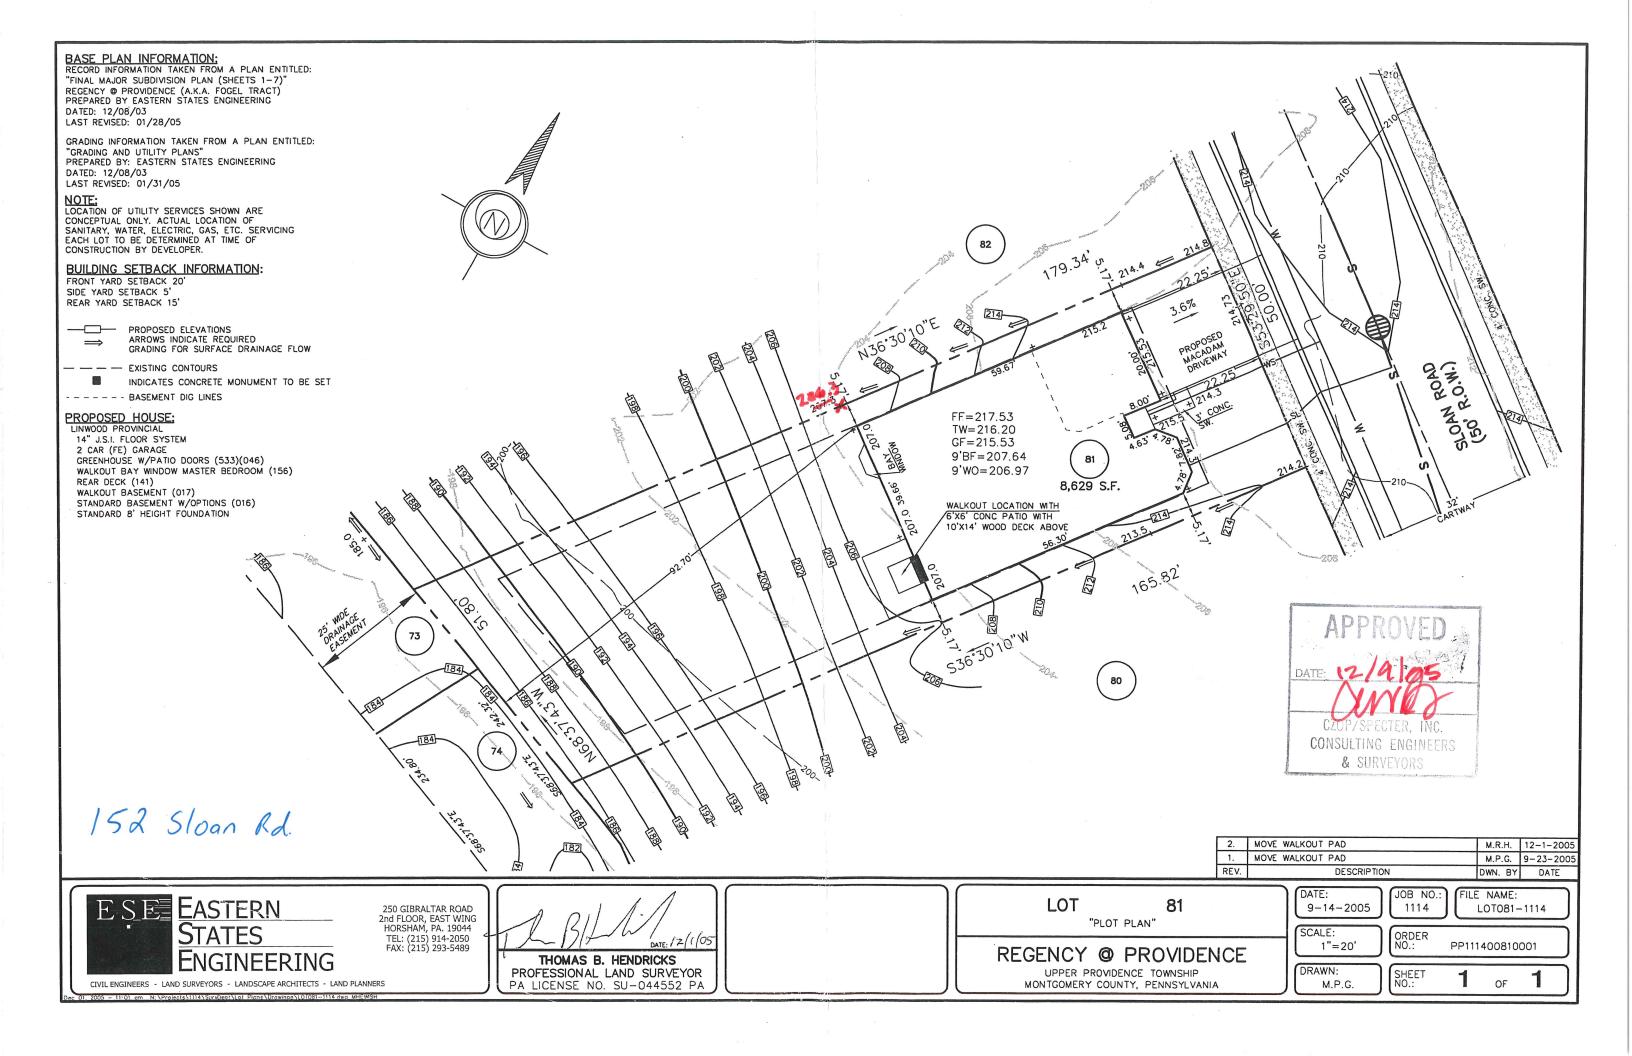

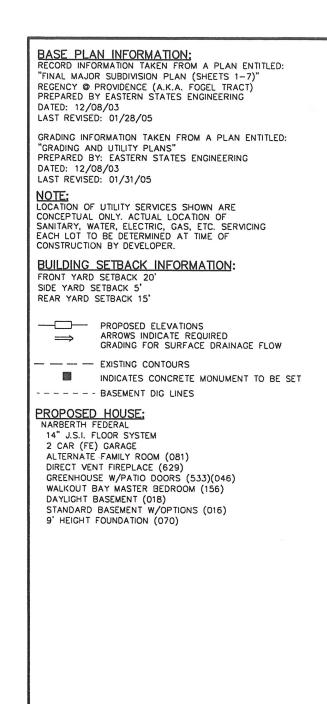

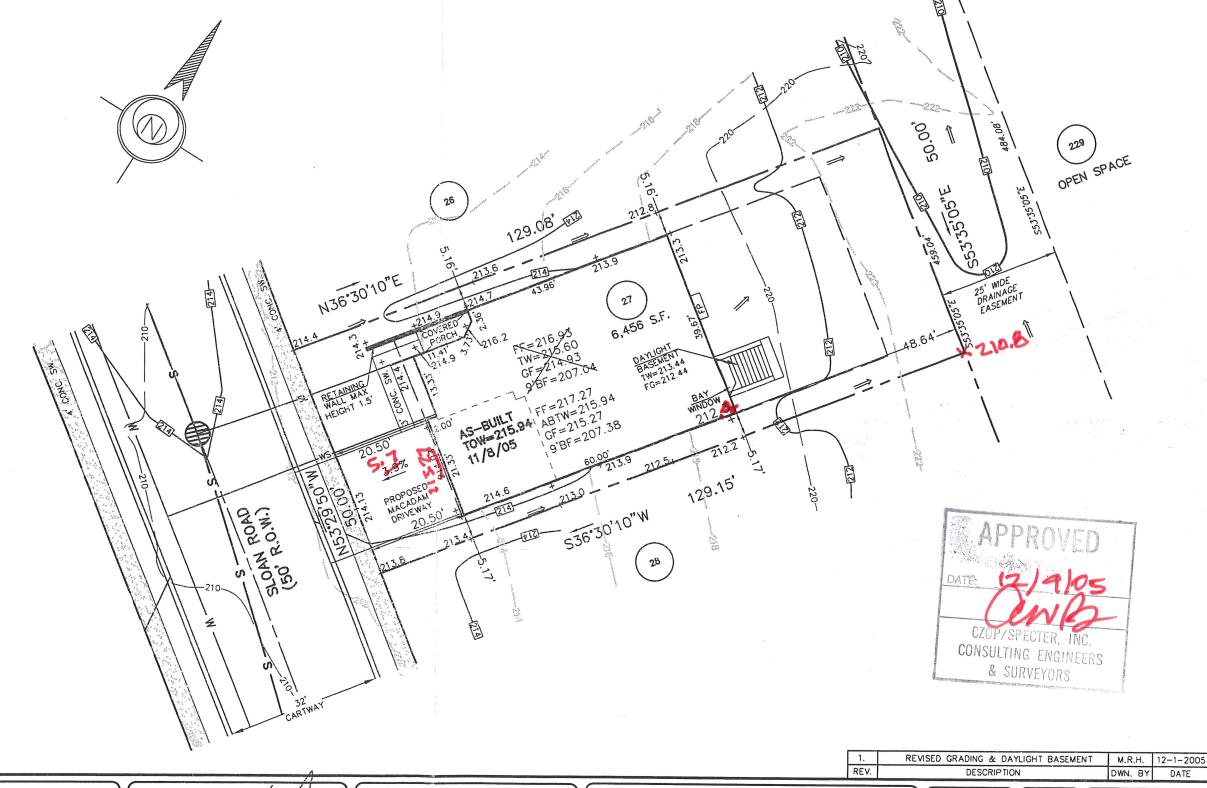

ESE EASTERN

153 Sloan Rd.

250 GIBRALTAR ROAD 2nd FLOOR, EAST WING HORSHAM, PA. 19044 TEL: (215) 914-2050 FAX: (215) 293-5489

THOMAS B. HENDRICKS PROFESSIONAL LAND SURVEYOR PA LICENSE NO. SU-044552 PA LOT

27

"PLOT PLAN"

REGENCY @ PROVIDENCE

MONTGOMERY COUNTY, PENNSYLVANIA

UPPER PROVIDENCE TOWNSHIP

DATE: 9-14-2005 JOB NO.: 1114

FILE NAME: LOT027-1114

SCALE: 1"=20' ORDER NO.: PP111400270001

DRAWN: M.P.G. OF

BASE PLAN INFORMATION: RECORD INFORMATION TAKEN FROM A PLAN ENTITLED: "FINAL MAJOR SUBDIVISION PLAN (SHEETS 1-7)" REGENCY @ PROVIDENCE (A.K.A. FOGEL TRACT)
PREPARED BY EASTERN STATES ENGINEERING DATED: 12/08/03 LAST REVISED: 01/28/05 GRADING INFORMATION TAKEN FROM A PLAN ENTITLED: "GRADING AND UTILITY PLANS" PREPARED BY: EASTERN STATES ENGINEERING DATED: 12/08/03 LAST REVISED: 01/31/05 NOTE: LOCATION OF UTILITY SERVICES SHOWN ARE CONCEPTUAL ONLY. ACTUAL LOCATION OF SANITARY, WATER, ELECTRIC, GAS, ETC. SERVICING 81 EACH LOT TO BE DETERMINED AT TIME OF CONSTRUCTION BY DEVELOPER. **BUILDING SETBACK INFORMATION:** FRONT YARD SETBACK 20' SIDE YARD SETBACK 5' N36°30'10"E 165.82 REAR YARD SETBACK 15' ROAD .O.W.) 214 PROPOSED ELEVATIONS
ARROWS INDICATE REQUIRED 213.5. GRADING FOR SURFACE DRAINAGE FLOW 568.37 20.50 SLOAN (50° R. - - - EXISTING CONTOURS 214.0 INDICATES CONCRETE MONUMENT TO BE SET 2.0% ---- BASEMENT DIG LINES 74 PROPOSED HOUSE: COVERED PORCH STOCKTON PROVINCIAL 14" J.S.I. FLOOR SYSTEM 2 CAR (FE) GARAGE FF=216.38 TG=181.00 SUNROOM W/ BASEMENT (027)(047) TW=215.05 194 REAR DECK (141) 80 GF = 214.38WALKOUT BASEMENT (017) 9'BF=206.49 STANDARD BASEMENT W/OPTIONS (016) 82.00° 9' HEIGHT FOUNDATION (070) 9'W0=205.80 8,112 S.F. S 34. 75 81,40' ≥ 54.83 N53.32'40"W 212.9 212.5  $\Leftarrow$ S36°30'10"W 161.56 25' WIDE DRAINAGE 79 154 Sloan Rd. REV. DESCRIPTION JOB NO.: ESE EASTERN LOT 80 10-10-2005 1114 250 GIBRALTAR ROAD 2nd FLOOR, EAST WING HORSHAM, PA. 19044 "PLOT PLAN" SCALE: ORDER NO.: TEL: (215) 914-2050 FAX: (215) 293-5489 DATE: 10/10/05 1"=20'

CIVIL ENGINEERS - LAND SURVEYORS - LANDSCAPE ARCHITECTS - LAND PLANNERS

THOMAS B. HENDRICKS PROFESSIONAL LAND SURVEYOR

PA LICENSE NO. SU-044552 PA

REGENCY @ PROVIDENCE

UPPER PROVIDENCE TOWNSHIP MONTGOMERY COUNTY, PENNSYLVANIA FILE NAME: LOT080-1114

DWN. BY DATE

PP111400800001

DRAWN: M.P.G.

SHEET NO.: OF

BASE PLAN INFORMATION:
RECORD INFORMATION TAKEN FROM A PLAN ENTITLED: "FINAL MAJOR SUBDIVISION PLAN (SHEETS 1-7)" REGENCY ® PROVIDENCE (A.K.A. FOGEL TRACT)
PREPARED BY EASTERN STATES ENGINEERING DATED: 12/08/03 LAST REVISED: 01/28/05 GRADING INFORMATION TAKEN FROM A PLAN ENTITLED: "GRADING AND UTILITY PLANS"
PREPARED BY: EASTERN STATES ENGINEERING DATED: 12/08/03 LAST REVISED: 01/31/05 NOTE:
LOCATION OF UTILITY SERVICES SHOWN ARE
CONCEPTUAL ONLY. ACTUAL LOCATION OF
SANITARY, WATER, ELECTRIC, GAS, ETC. SERVICING
EACH LOT TO BE DETERMINED AT TIME OF
CONSTRUCTION BY DEVELOPER. **BUILDING SETBACK INFORMATION:** FRONT YARD SETBACK 20' SIDE YARD SETBACK 5' REAR YARD SETBACK 15' PROPOSED ELEVATIONS ARROWS INDICATE REQUIRED GRADING FOR SURFACE DRAINAGE FLOW - EXISTING CONTOURS A. INDICATES CONCRETE MONUMENT TO BE SET ---- BASEMENT DIG LINES PROPOSED HOUSE: STOCKTON FEDERAL 14" J.S.I. FLOOR SYSTEM 2 CAR (FE) GARAGE SUNROOM ADDITION W/BASEMENT (027)(047) DAYLIGHT WINDOW (543) STANDARD BASEMENT W/OPTIONS (016) STANDARD 8' HEIGHT FOUNDATION 155 Sloan Rd.

25' WIDE DRAINAGE EASEMENT 50 129.15 N36°30'10"E \$53<sup>35</sup>05<sup>7E</sup> 5555555555555 DAYLIGHT WINDOW TW= 214.07 FG= 213.74 AS-BUILT AS-BUILT TOW=214.95 TOW=214.95 11/8/05 ABTW=214.95 ABTW=214.98 GF=214.28 6,460 S.F. 8BF=207.34 48.72 GF=214.28 8'BF=207.39 ROAD 0. K.) 210.8 SLOAN (50' R. 129.23 5 536'30'10"W

E S E EASTERN ENGINEERING

250 GIBRALTAR ROAD 2nd FLOOR, EAST WING HORSHAM, PA. 19044 TEL: (215) 914-2050 FAX: (215) 293-5489

THOMAS B. HENDRICKS

LOT

28

REV.

"PLOT PLAN"

REGENCY @ PROVIDENCE

UPPER PROVIDENCE TOWNSHIP MONTGOMERY COUNTY, PENNSYLVANIA DATE: 9-14-2005

REVISED GRADING

ADD DAYLIGHT WINDOW

DESCRIPTION

**APPROVED** 

CZOP/SPECTER, INC. CONSULTING ENGINEERS

& SURVEYORS

JOB NO.: FILE NAME: 1114 LOT028-1114

S.J.C. 11-25-2005

MRH 10-31-2005

DWN. BY DATE

OPEN SPACE

SCALE: 1"=20'

PP111400280001

DRAWN: SHEET NO.: OF M.P.G.

PROFESSIONAL LAND SURVEYOR PA LICENSE NO. SU-044552 PA

BASE PLAN INFORMATION: RECORD INFORMATION TAKEN FROM A PLAN ENTITLED: "FINAL MAJOR SUBDIVISION PLAN (SHEETS 1-7)" REGENCY @ PROVIDENCE (A.K.A. FOGEL TRACT)
PREPARED BY EASTERN STATES ENGINEERING DATED: 12/08/03 LAST REVISED: 01/28/05 GRADING INFORMATION TAKEN FROM A PLAN ENTITLED: "GRADING AND UTILITY PLANS" PREPARED BY: EASTERN STATES ENGINEERING DATED: 12/08/03 LAST REVISED: 01/31/05 NOTE: LOCATION OF UTILITY SERVICES SHOWN ARE CONCEPTUAL ONLY. ACTUAL LOCATION OF SANITARY, WATER, ELECTRIC, GAS, ETC. SERVICING EACH LOT TO BE DETERMINED AT TIME OF 161.56 CONSTRUCTION BY DEVELOPER. BUILDING SETBACK INFORMATION: FRONT YARD SETBACK 20' SIDE YARD SETBACK 5' (50 B) REAR YARD SETBACK 15' PROPOSED ELEVATIONS
ARROWS INDICATE REQUIRED  $\Longrightarrow$ GRADING FOR SURFACE DRAINAGE FLOW - - - EXISTING CONTOURS INDICATES CONCRETE MONUMENT TO BE SET `20<sub>0</sub>, ---- BASEMENT DIG LINES PROPOSED HOUSE: 79 STAMFORD FEDERAL

14" J.S.I. FLOOR SYSTEM

2 CAR (FE) GARAGE
SUNROOM ADDITION W/BASEMENT (027)(047) 8,065 S.F. = REAR DECK (141) WALK OUT BASEMENT (017)
STANDARD BASEMENT W/OPTIONS (016) 9'BF=205.32 9' HEIGHT FOUNDATION (070) 闡 3.WO=204.70 ,59.15 APPROVED CZOP/SPECTER, INC. CONSULTING ENGINEERS & SURVEYORS 156 Sloan Rd. COMPACT STOTE EST. 76 1. MOVE WALKOUT PAR REV. DESCRIPTION DATE: JOB NO .: ESTERN EASTERN LOT 79 250 GIBRALTAR ROAD 9-14-2005 1114 2nd FLOOR, EAST WING HORSHAM, PA. 19044 TEL: (215) 914-2050 FAX: (215) 293-5489 "PLOT PLAN" SCALE: 1"=20' REGENCY @ PROVIDENCE ENGINEERING

THOMAS B. HENDRICKS

PROFESSIONAL LAND SURVEYOR

PA LICENSE NO. SU-044552 PA

CIVIL ENGINEERS - LAND SURVEYORS - LANDSCAPE ARCHITECTS - LAND PLANNERS

M.P.G. 9-23-200

DATE

DWN. BY

LOT079-1114

FILE NAME:

PP111400790001

OF

DRAWN:

M.P.G.


SHEET NO.:

UPPER PROVIDENCE TOWNSHIP

MONTGOMERY COUNTY, PENNSYLVANIA

BASE PLAN INFORMATION:
RECORD INFORMATION TAKEN FROM A PLAN ENTITLED:
"FINAL MAJOR SUBDIVISION PLAN (SHEETS 1-7)"
REGENCY ® PROVIDENCE (A.K.A. FOGEL TRACT)
PREPARED BY EASTERN STATES ENGINEERING DATED: 12/08/03 LAST REVISED: 01/28/05 GRADING INFORMATION TAKEN FROM A PLAN ENTITLED: "GRADING AND UTILITY PLANS"
PREPARED BY: EASTERN STATES ENGINEERING DATED: 12/08/03 LAST REVISED: 01/31/05 NOTE: LOCATION OF UTILITY SERVICES SHOWN ARE CONCEPTUAL ONLY. ACTUAL LOCATION OF SANITARY, WATER, ELECTRIC, GAS, ETC. SERVICING EACH LOT TO BE DETERMINED AT TIME OF CONSTRUCTION BY DEVELOPER. **BUILDING SETBACK INFORMATION:** FRONT YARD SETBACK 20' SIDE YARD SETBACK 5' REAR YARD SETBACK 15' \_\_\_\_ PROPOSED ELEVATIONS ARROWS INDICATE REQUIRED GRADING FOR SURFACE DRAINAGE FLOW - EXISTING CONTOURS ---- BASEMENT DIG LINES PROPOSED HOUSE: 14" J.S.I. FLOOR SYSTEM 2 CAR (FE) GARAGE DAYLIGHT WINDOW (543) STANDARD BASEMENT W/OPTIONS (016) 9' HEIGHT FOUNDATION (070)

157 Sloan Rd.

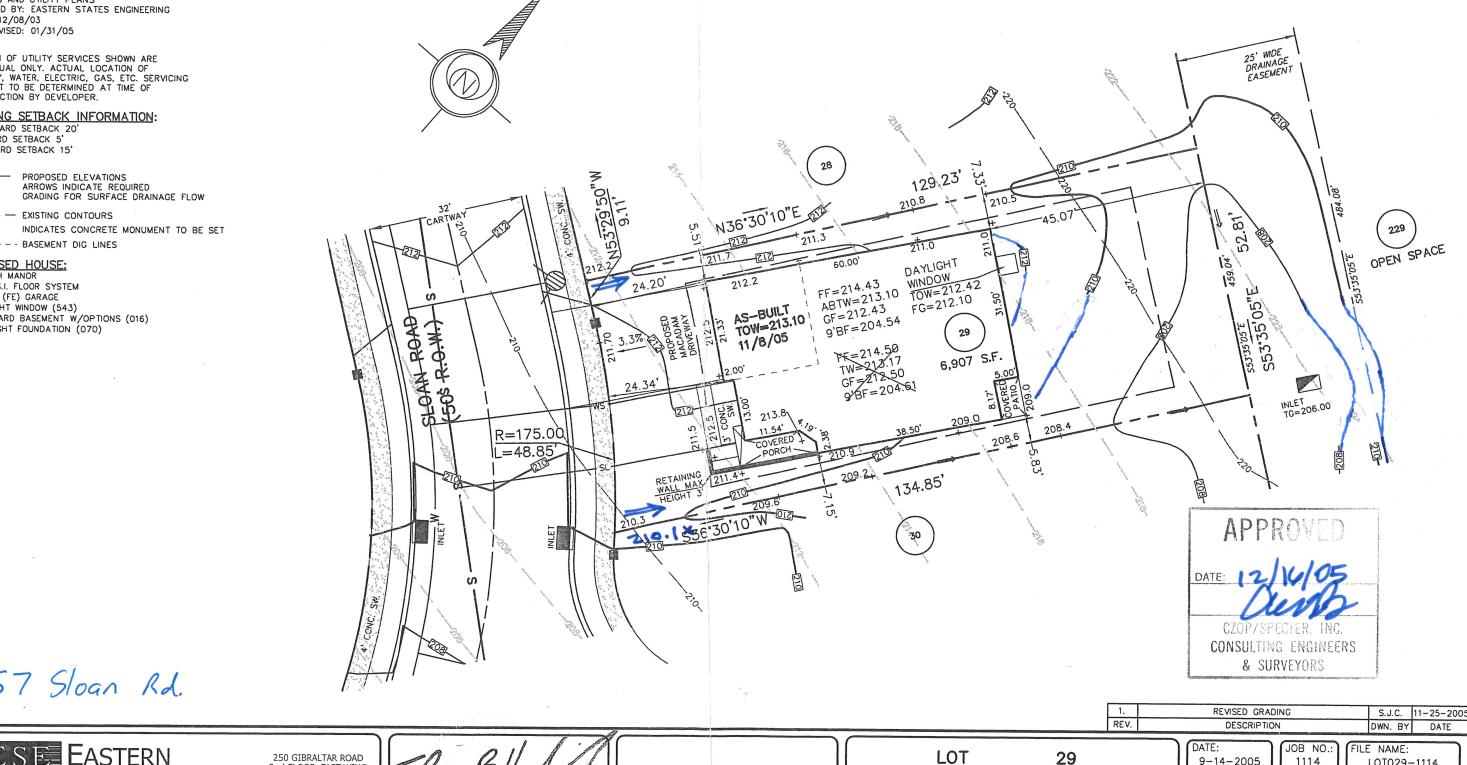

ESE EASTERN **ENGINEERING** 

250 GIBRALTAR ROAD 2nd FLOOR, EAST WING HORSHAM, PA. 19044 TEL: (215) 914-2050 FAX: (215) 293-5489

THOMAS B. HENDRICKS PROFESSIONAL LAND SURVEYOR PA LICENSE NO. SU-044552 PA REGENCY @ PROVIDENCE UPPER PROVIDENCE TOWNSHIP

MONTGOMERY COUNTY, PENNSYLVANIA

"PLOT PLAN"

9-14-2005

1114

SCALE: 1"=20'


LOT029-1114 ORDER NO.:

PP111400290001

DRAWN: M.P.G. SHEET NO.: OF

BASE PLAN INFORMATION:
RECORD INFORMATION TAKEN FROM A PLAN ENTITLED: "FINAL MAJOR SUBDIVISION PLAN (SHEETS 1-7)" REGENCY PROVIDENCE (A.K.A. FOGEL TRACT)
PREPARED BY EASTERN STATES ENGINEERING DATED: 12/08/03 LAST REVISED: 01/28/05 GRADING INFORMATION TAKEN FROM A PLAN ENTITLED: "GRADING AND UTILITY PLANS"
PREPARED BY: EASTERN STATES ENGINEERING DATED: 12/08/03 LAST REVISED: 01/31/05 NOTE: LOCATION OF UTILITY SERVICES SHOWN ARE CONCEPTUAL ONLY. ACTUAL LOCATION OF SANITARY, WATER, ELECTRIC, GAS, ETC. SERVICING EACH LOT TO BE DETERMINED AT TIME OF CONSTRUCTION BY DEVELOPER. BUILDING SETBACK INFORMATION: FRONT YARD SETBACK 20' SIDE YARD SETBACK 5' REAR YARD SETBACK 15' \_\_\_\_ PROPOSED ELEVATIONS ARROWS INDICATE REQUIRED GRADING FOR SURFACE DRAINAGE FLOW EXISTING CONTOURS INDICATES CONCRETE MONUMENT TO BE SET ---- BASEMENT DIG LINES PROPOSED HOUSE: STOCKTON FEDERAL 14" J.S.I. FLOOR SYSTEM 2 CAR (FE) GARAGE SARASOTA SUNROOM W/BASEMENT (027)(047) DAYLIGHT BASEMENT (018) STANDARD BASEMENT W/OPTIONS (016) STANDARD 8' HEIGHT FOUNDATION

159 Sloan Rd.

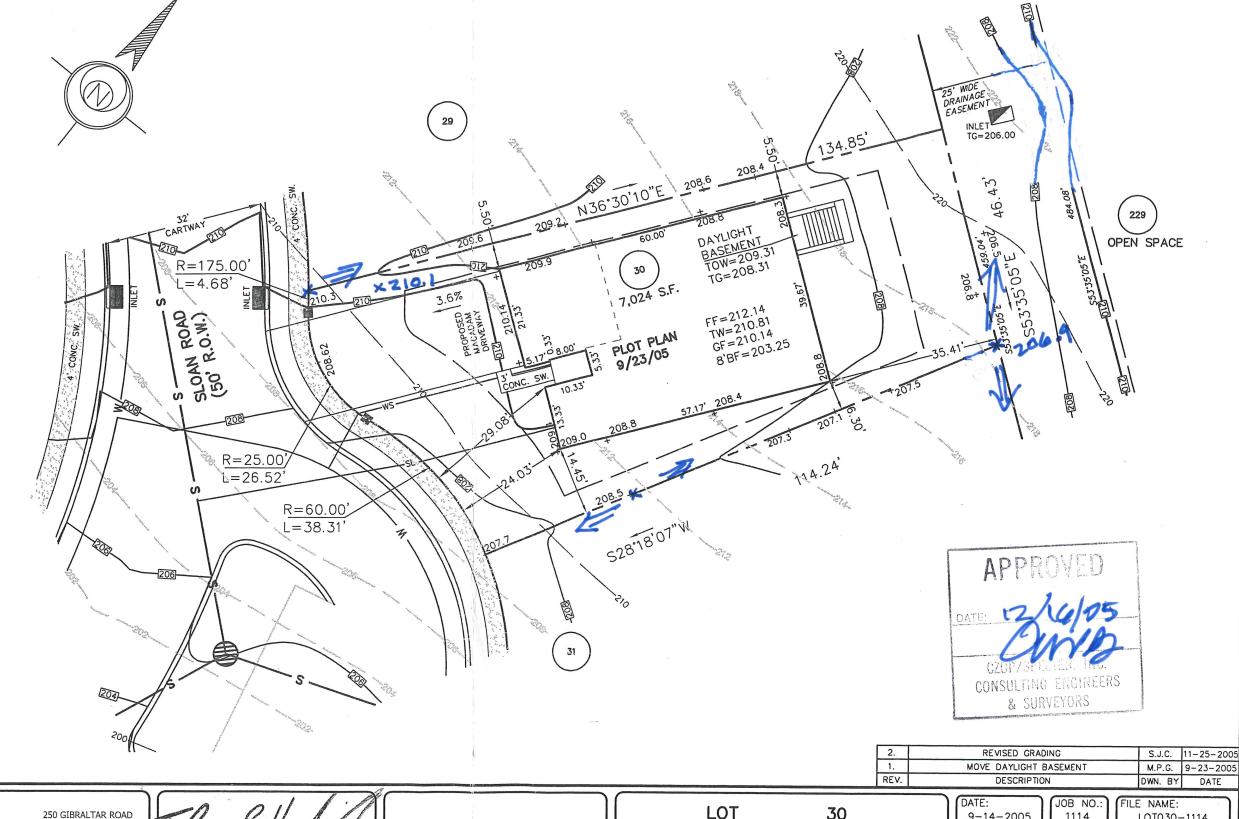



250 GIBRALTAR ROAD 2nd FLOOR, EAST WING HORSHAM, PA. 19044 TEL: (215) 914-2050 FAX: (215) 293-5489

THOMAS B. HENDRICKS

30

"PLOT PLAN"

REGENCY @ PROVIDENCE

UPPER PROVIDENCE TOWNSHIP MONTGOMERY COUNTY, PENNSYLVANIA 9-14-2005

1114

LOT030-1114

SCALE: 1"=20'


ORDER NO.: PP111400300001


DRAWN: SHEET NO.: M.P.G.


OF


CIVIL ENGINEERS - LAND SURVEYORS - LANDSCAPE ARCHITECTS - LAND PLANNERS

PROFESSIONAL LAND SURVEYOR PA LICENSE NO. SU-044552 PA

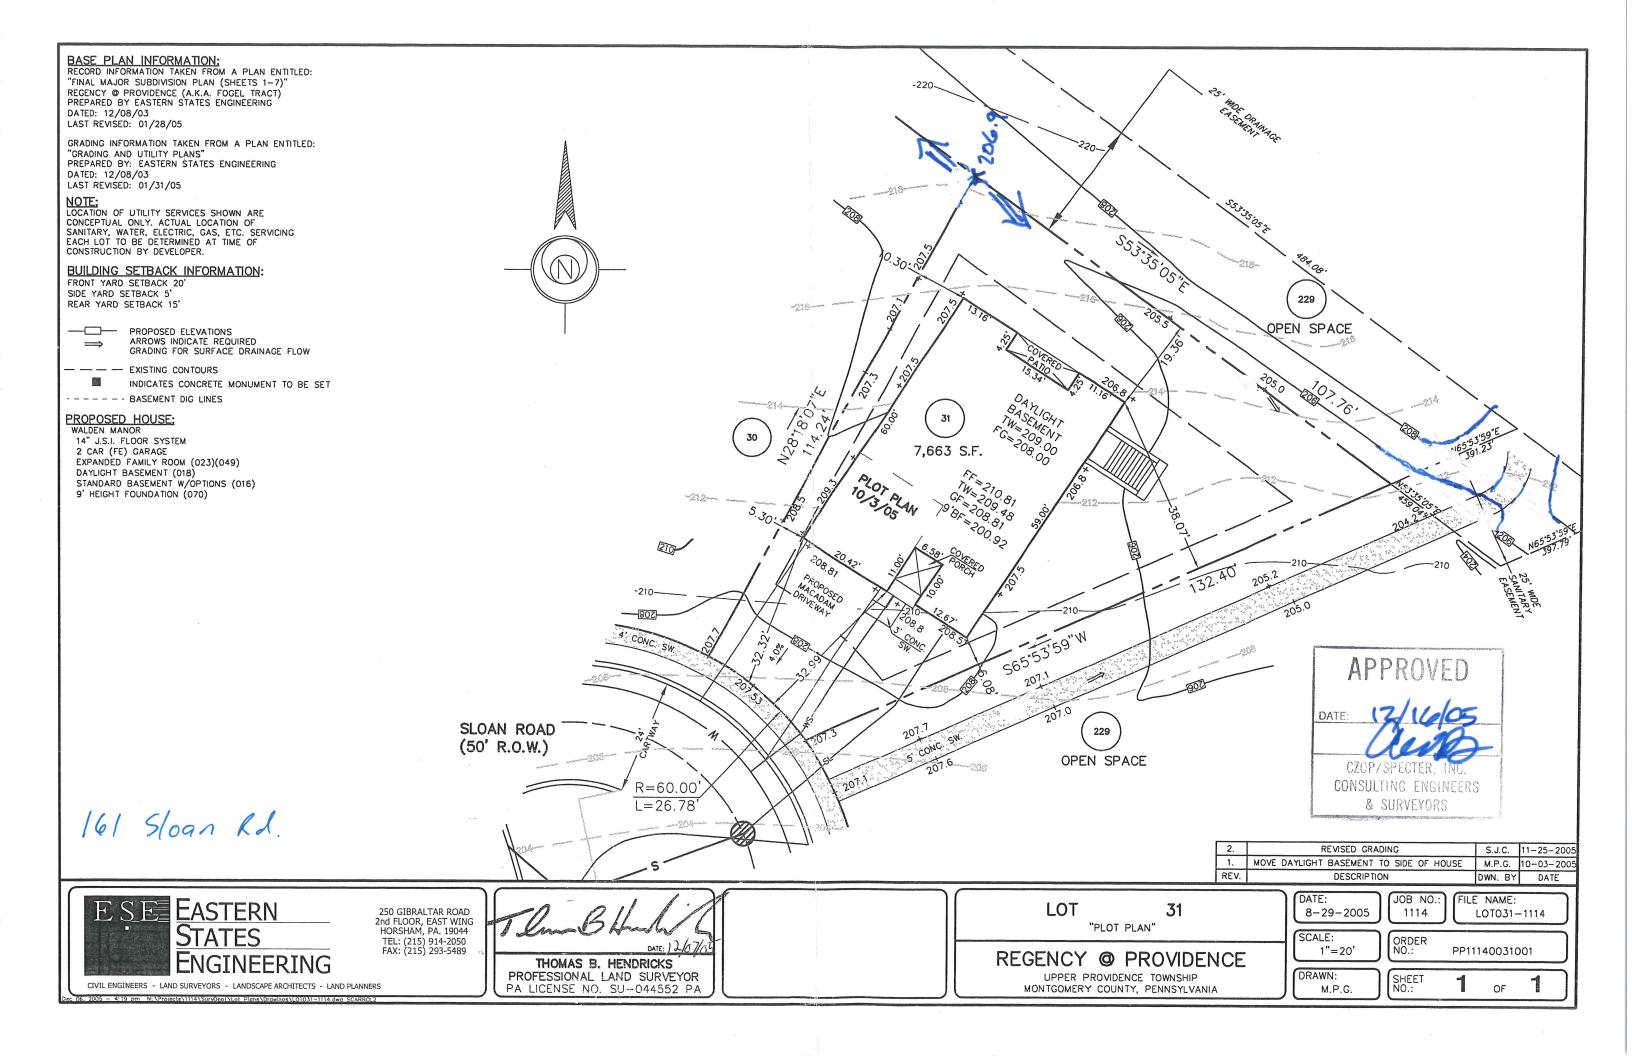

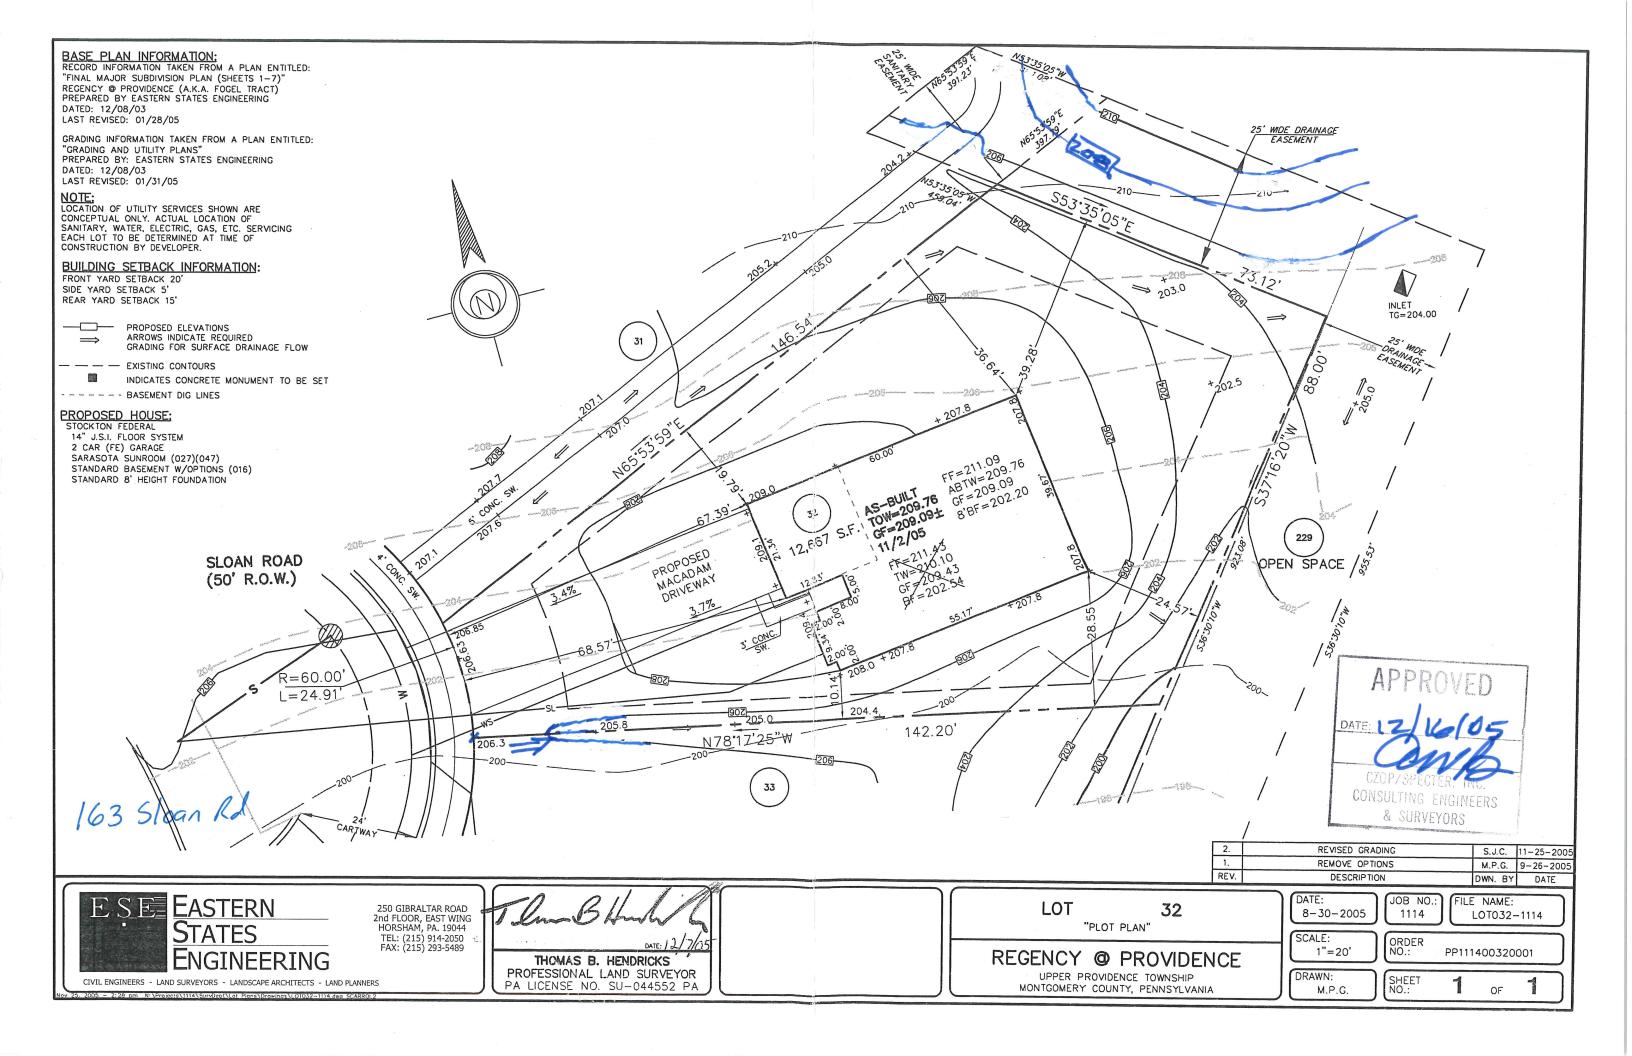

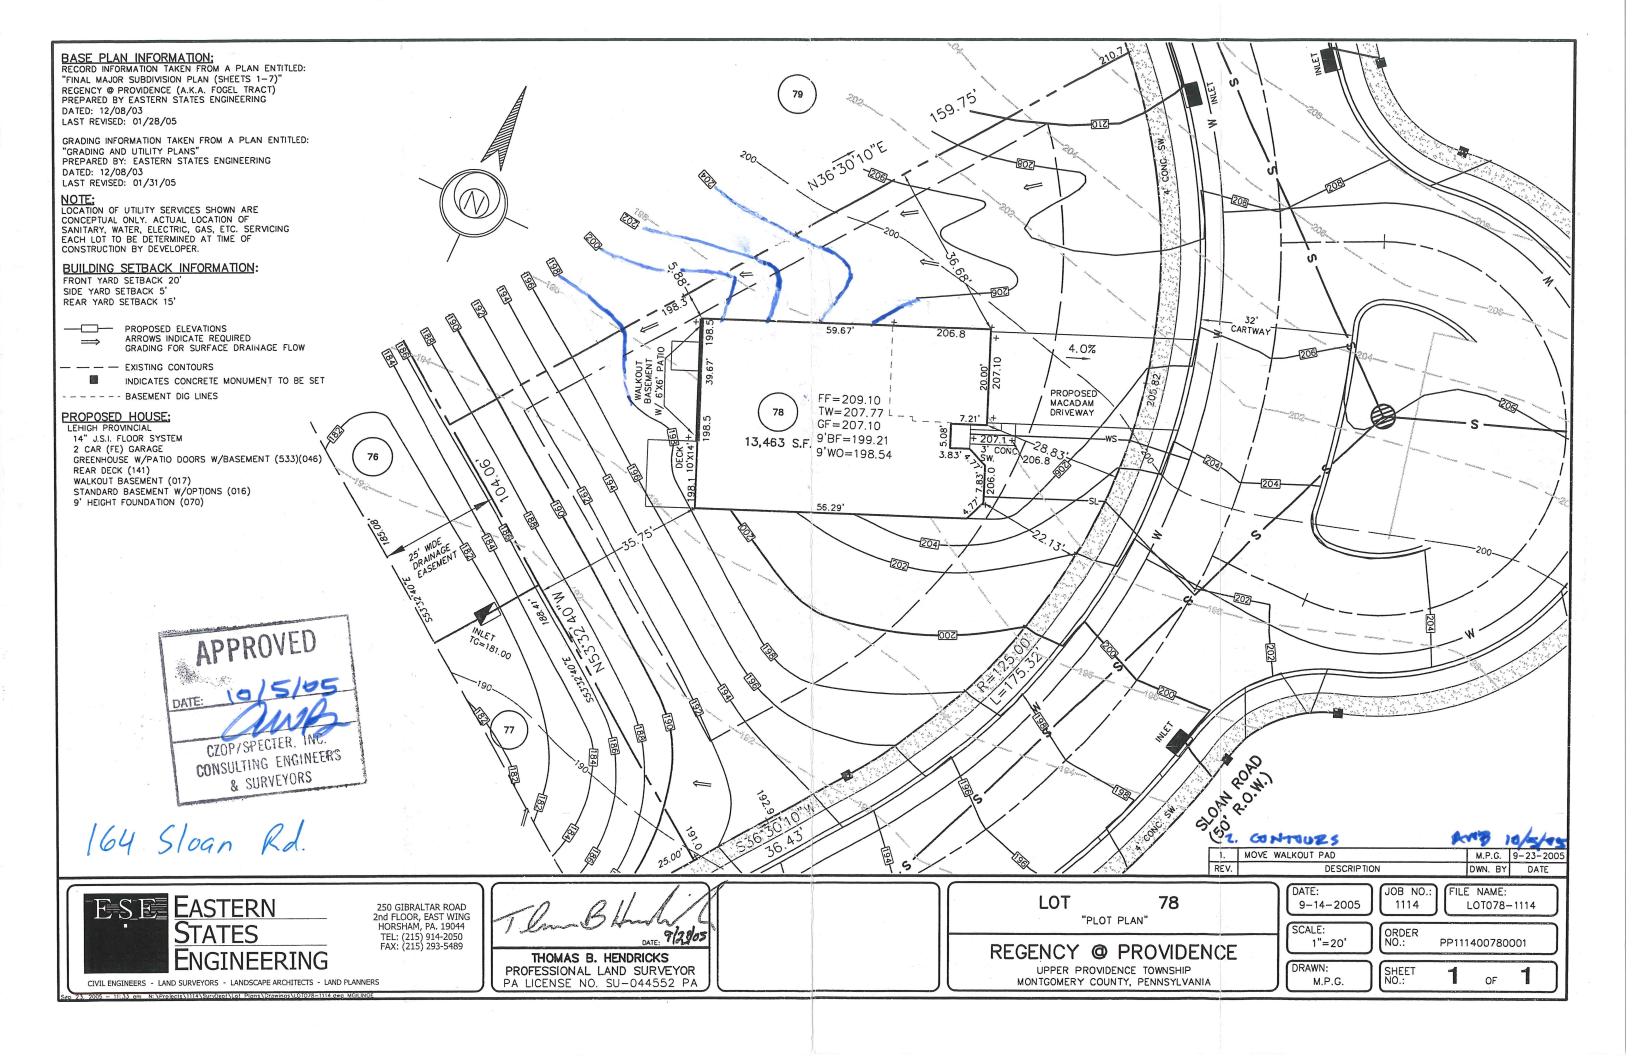

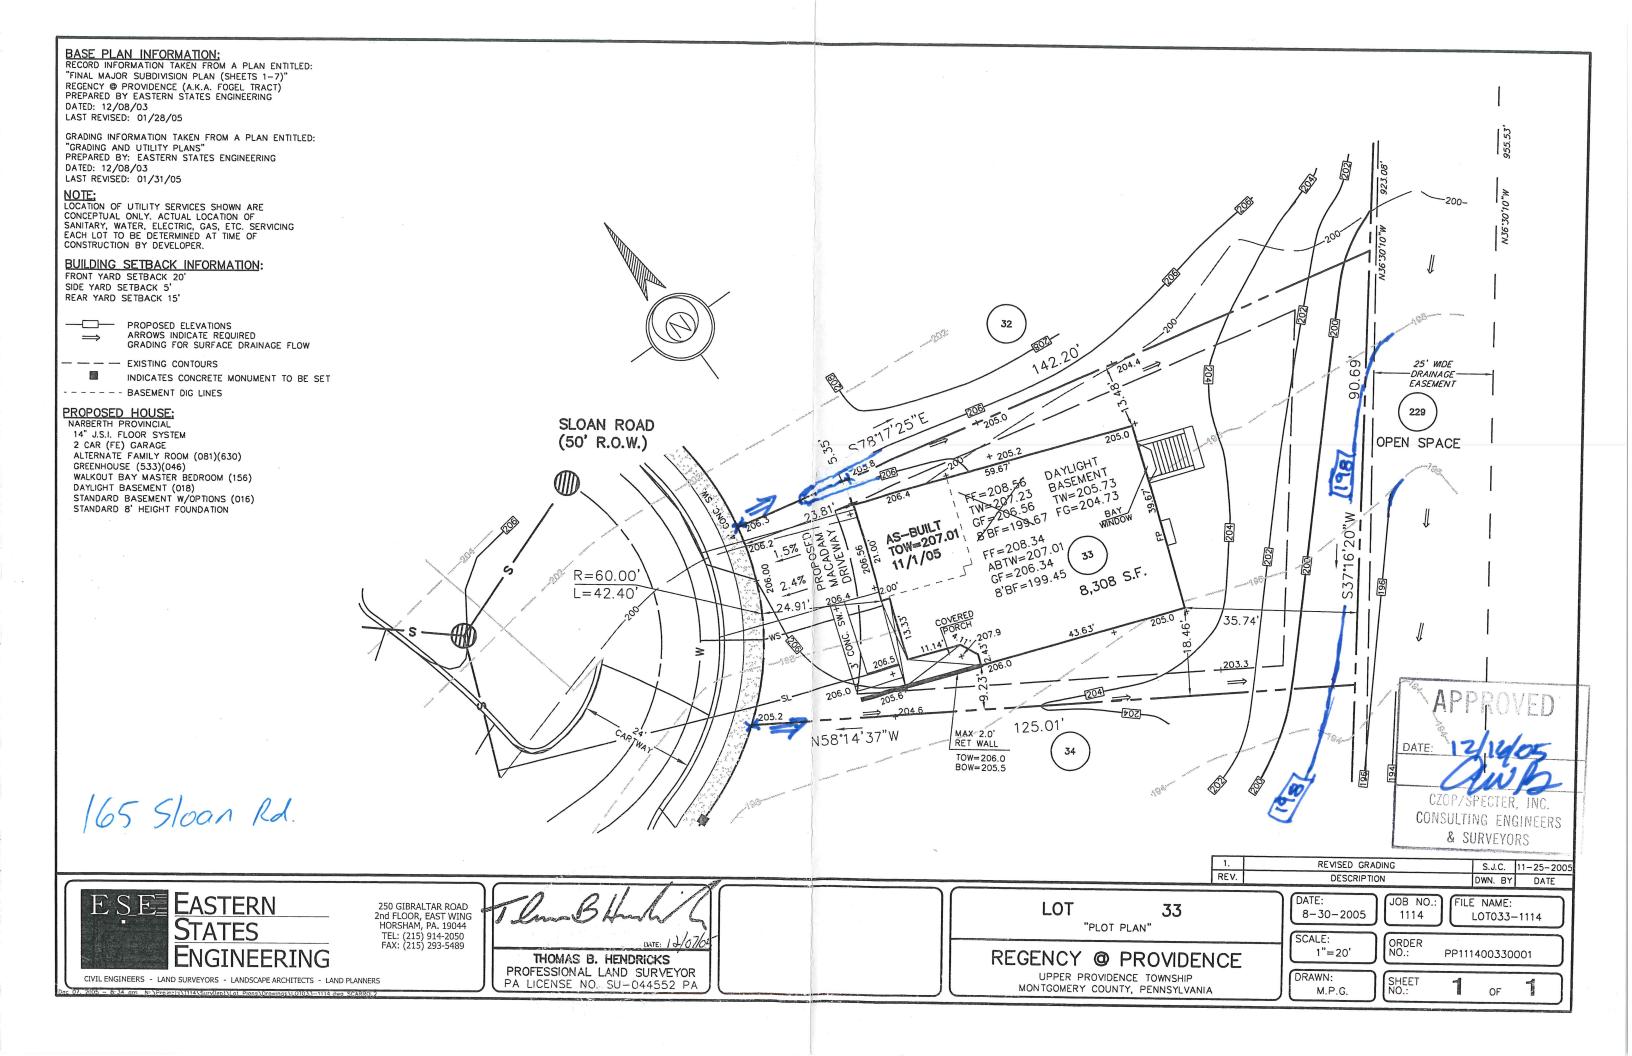

BASE PLAN INFORMATION: RECORD INFORMATION TAKEN FROM A PLAN ENTITLED: "FINAL MAJOR SUBDIVISION PLAN (SHEETS 1-7)" REGENCY @ PROVIDENCE (A.K.A. FOGEL TRACT) PREPARED BY EASTERN STATES ENGINEERING DATED: 12/08/03 LAST REVISED: 01/28/05

GRADING INFORMATION TAKEN FROM A PLAN ENTITLED: "GRADING AND UTILITY PLANS" PREPARED BY: EASTERN STATES ENGINEERING DATED: 12/08/03 LAST REVISED: 01/31/05

NOTE:
LOCATION OF UTILITY SERVICES SHOWN ARE
CONCEPTUAL ONLY. ACTUAL LOCATION OF
SANITARY, WATER, ELECTRIC, GAS, ETC. SERVICING
EACH LOT TO BE DETERMINED AT TIME OF CONSTRUCTION BY DEVELOPER.

### **BUILDING SETBACK INFORMATION:**

FRONT YARD SETBACK 20' SIDE YARD SETBACK 5' REAR YARD SETBACK 15'

 $\Longrightarrow$ 

PROPOSED ELEVATIONS
ARROWS INDICATE REQUIRED

GRADING FOR SURFACE DRAINAGE FLOW

EXISTING CONTOURS

INDICATES CONCRETE MONUMENT TO BE SET

---- BASEMENT DIG LINES

## PROPOSED HOUSE: LEHIGH WILLIAMSBURG

14" J.S.I. FLOOR SYSTEM 2 CAR (FE) GARAGE SARASOTA SUNROOM (027)(047) DAYLIGHT WINDOW (543) STANDARD BASEMENT W/OPTIONS (016) 9' HEIGHT FOUNDATION (070)

R = 60.00'L = 22.23'25' WIDE DRAINAGE -33 EASEMENT \_= S58°14'37" 204.6 +204.6 205.2 PROP. CCRNER 205.6 204.4 60.00 4 50, Ω 0.34' 204.95 DAYLIGHT 3.4% 34 WINDOW PROPOSED TW=205.85 8 8 6,789 S.F. MACADAM FG = 205.52AS-BUILT DRIVEWAY 229 TOW=206.49 10/25/05 OPEN SPACE FF=207,83 FF=207.82 205.9+ ABTW=206.49 TW=206.60 GF=205.93 3' CONC./ Ŕ=25.00' GF = 205.82ØBF=198.04 9'BF=197.93 L = 26.52R = 175.00199.0 ⇒ 197.0 -TG=192.00 134.31 N58°14'37"W CONSULTING ENGINEERS & SURVEYORS REVISED GRADING S.J.C. 11-29-2005 REV. DESCRIPTION DWN. BY DATE

167 Sloan Road



250 GIBRALTAR ROAD 2nd FLOOR, EAST WING HORSHAM, PA. 19044 TEL: (215) 914-2050 FAX: (215) 293-5489

THOMAS B. HENDRICKS

REGENCY @ PROVIDENCE UPPER PROVIDENCE TOWNSHIP

"PLOT PLAN"

MONTGOMERY COUNTY, PENNSYLVANIA

34

LOT

DATE: 8-30-2005

JOB NO.: 1114

FILE NAME: LOT034-1114

SCALE: 1"=20'

ORDER NO.: PP111400340001

DRAWN: M.P.G.

SHEET NO.: OF

CIVIL ENGINEERS - LAND SURVEYORS - LANDSCAPE ARCHITECTS - LAND PLANNERS

PROFESSIONAL LAND SURVEYOR PA LICENSE NO. SU-044552 PA

BASE PLAN INFORMATION:
RECORD INFORMATION TAKEN FROM A PLAN ENTITLED: "FINAL MAJOR SUBDIVISION PLAN (SHEETS 1-7)" REGENCY @ PROVIDENCE (A.K.A. FOGEL TRACT)
PREPARED BY EASTERN STATES ENGINEERING DATED: 12/08/03

GRADING INFORMATION TAKEN FROM A PLAN ENTITLED: "GRADING AND UTILITY PLANS" PREPARED BY: EASTERN STATES ENGINEERING DATED: 12/08/03 LAST REVISED: 01/31/05

NOTE: LOCATION OF UTILITY SERVICES SHOWN ARE CONCEPTUAL ONLY. ACTUAL LOCATION OF
SANITARY, WATER, ELECTRIC, GAS, ETC. SERVICING
EACH LOT TO BE DETERMINED AT TIME OF
CONSTRUCTION BY DEVELOPER.

### **BUILDING SETBACK INFORMATION:**

FRONT YARD SETBACK 20' SIDE YARD SETBACK 5' REAR YARD SETBACK 15'

LAST REVISED: 01/28/05


PROPOSED ELEVATIONS ARROWS INDICATE REQUIRED
GRADING FOR SURFACE DRAINAGE FLOW  $\Longrightarrow$ 

EXISTING CONTOURS INDICATES CONCRETE MONUMENT TO BE SET

---- BASEMENT DIG LINES

# PROPOSED HOUSE:

14" J.S.I. FLOOR SYSTEM 2 CAR (FE) GARAGE ALTERNATE FAMILY ROOM (081)(629) GREENHOUSE (533)(046) WALKOUT BAY WINDOW (156) DAYLIGHT BASEMENT (018) STANDARD BASEMENT W/OPTIONS (016) STANDARD 8' HEIGHT FOUNDATION

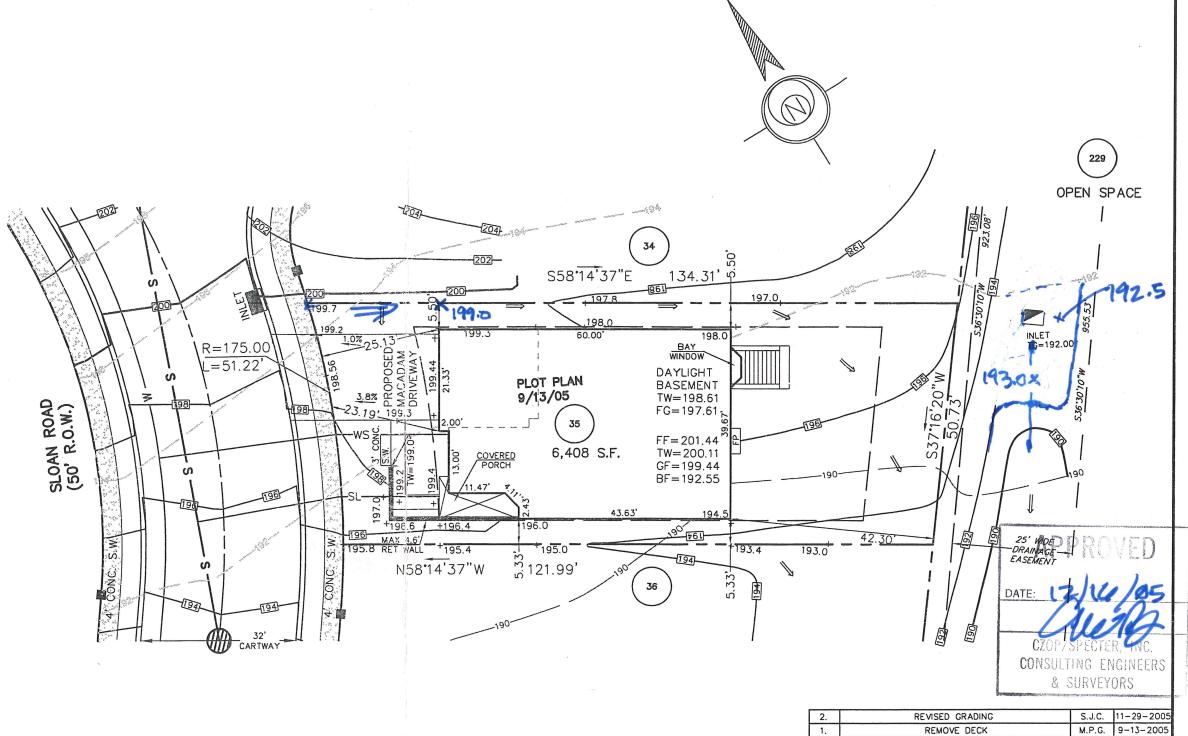

169 Sloan Rd.

				REV.	
E S E EASTERN	250 GIBRALTAR ROAD 2nd FLOOR, EAST WING HORSHAM, PA. 19044	ThuBHM/	LOT 35	DAT 8-	-30
SIAIES	TEL: (215) 914-2050 FAX: (215) 293-5489	DATE: 12/7/15	RECENCY @ PROVIDE	VCF L	1"

CIVIL ENGINEERS - LAND SURVEYORS - LANDSCAPE ARCHITECTS - LAND PLANNERS

**ENGINEERING** 

REGENCY @ PROVIDENCE THOMAS B. HENDRICKS PROFESSIONAL LAND SURVEYOR PA LICENSE NO. SU-044552 PA

UPPER PROVIDENCE TOWNSHIP

MONTGOMERY COUNTY, PENNSYLVANIA

30-2005

DESCRIPTION

JOB NO.: 1114

FILE NAME: LOT035-1114

DWN. BY DATE

ALE: 1"=20' ORDER NO.: PP111400350001

DRAWN: M.P.G.

SHEET NO.: OF

BASE PLAN INFORMATION: RECORD INFORMATION TAKEN FROM A PLAN ENTITLED: "FINAL MAJOR SUBDIVISION PLAN (SHEETS 1-7)" REGENCY @ PROVIDENCE (A.K.A. FOGEL TRACT) PREPARED BY EASTERN STATES ENGINEERING DATED: 12/08/03

LAST REVISED: 01/28/05

GRADING INFORMATION TAKEN FROM A PLAN ENTITLED: "GRADING AND UTILITY PLANS"
PREPARED BY: EASTERN STATES ENGINEERING DATED: 12/08/03 LAST REVISED: 01/31/05

NOTE:
LOCATION OF UTILITY SERVICES SHOWN ARE
CONCEPTUAL ONLY. ACTUAL LOCATION OF
SANITARY, WATER, ELECTRIC, GAS, ETC. SERVICING
EACH LOT TO BE DETERMINED AT TIME OF
CONSTRUCTION BY DEVELOPER.

#### BUILDING SETBACK INFORMATION:

FRONT YARD SETBACK 20' SIDE YARD SETBACK 5' REAR YARD SETBACK 15'

PROPOSED ELEVATIONS

ARROWS INDICATE REQUIRED


GRADING FOR SURFACE DRAINAGE FLOW

INDICATES CONCRETE MONUMENT TO BE SET

---- BASEMENT DIG LINES

## PROPOSED HOUSE:

14" J.S.I. FLOOR SYSTEM 2 CAR (FE) GARAGE ALTERNATE FAMILY ROOM (081)(629) STANDARD BASEMENT W/OPTIONS (016) STANDARD 8' HEIGHT FOUNDATION

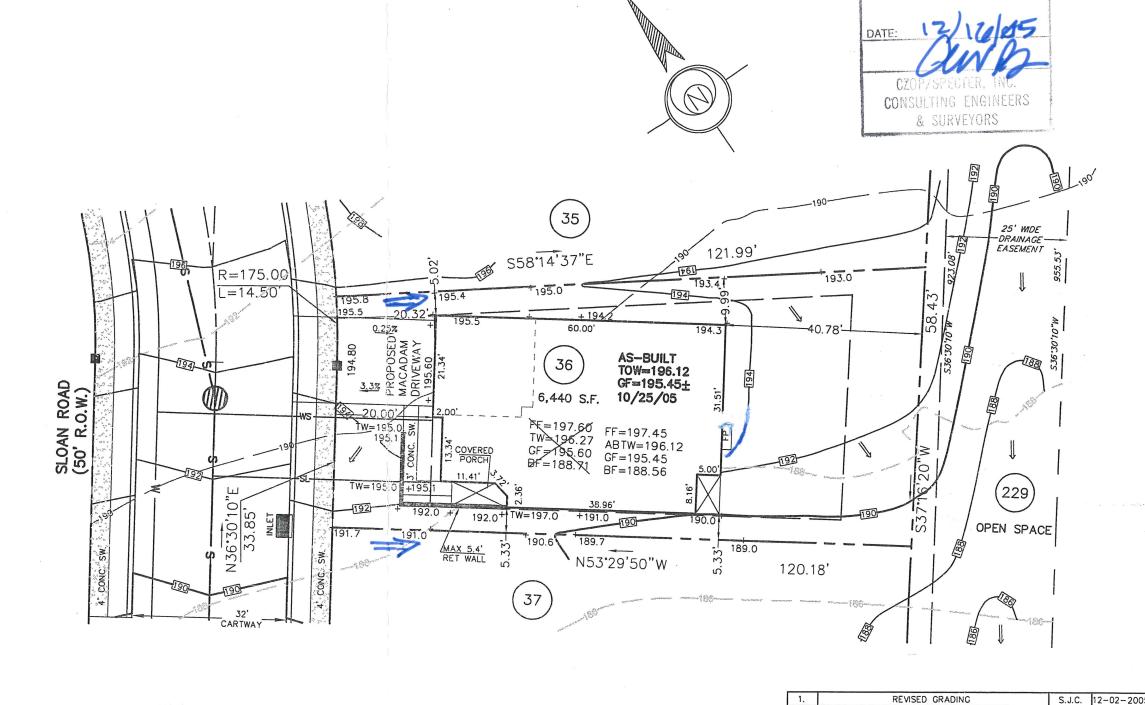

171 Sloan Rd

ESE EASTERN **ENGINEERING** 

250 GIBRALTAR ROAD 2nd FLOOR, EAST WING HORSHAM, PA. 19044 TEL: (215) 914-2050 FAX: (215) 293-5489

THOMAS B. HENDRICKS PROFESSIONAL LAND SURVEYOR

PA LICENSE NO. SU-044552 PA

LOT 36 "PLOT PLAN"

REGENCY @ PROVIDENCE

SCALE: 1"=20'

9-1-2005

JOB NO.: FILE NAME: 1114 LOT036-1114

DWN. BY DATE

OF

ORDER NO.: PP111400360001

UPPER PROVIDENCE TOWNSHIP MONTGOMERY COUNTY, PENNSYLVANIA

REV.

DRAWN: SHEET NO.: M.P.G.

DESCRIPTION

BASE PLAN INFORMATION:
RECORD INFORMATION TAKEN FROM A PLAN ENTITLED: "FINAL MAJOR SUBDIVISION PLAN (SHEETS 1-7)" REGENCY @ PROVIDENCE (A.K.A. FOGEL TRACT) PREPARED BY EASTERN STATES ENGINEERING DATED: 12/08/03

LAST REVISED: 01/28/05

GRADING INFORMATION TAKEN FROM A PLAN ENTITLED: "GRADING AND UTILITY PLANS"
PREPARED BY: EASTERN STATES ENGINEERING DATED: 12/08/03 LAST REVISED: 01/31/05

NOTE:
LOCATION OF UTILITY SERVICES SHOWN ARE
CONCEPTUAL ONLY. ACTUAL LOCATION OF SANITARY, WATER, ELECTRIC, GAS, ETC. SERVICING EACH LOT TO BE DETERMINED AT TIME OF CONSTRUCTION BY DEVELOPER.

### **BUILDING SETBACK INFORMATION:**

FRONT YARD SETBACK 20' SIDE YARD SETBACK 5' REAR YARD SETBACK 15'

PROPOSED ELEVATIONS

ARROWS INDICATE REQUIRED

GRADING FOR SURFACE DRAINAGE FLOW

INDICATES CONCRETE MONUMENT TO BE SET

---- BASEMENT DIG LINES

# PROPOSED HOUSE: LINWOOD PROVINCIAL

14" J.S.I. FLOOR SYSTEM 2 CAR (FE) GARAGE GREENHOUSE (533)(046) DAYLIGHT BASEMENT (018) STANDARD BASEMENT W/OPTIONS (016) 9' HEIGHT FOUNDATION (070)

25' WIDE DRAINAGE -EASEMENT 36 S53'29'50"E 120.18' 189.0 189.8 + 189.9 59.67 189.6 0.4% DAYLIGHT BASEMENT TW=189,45 37 FG=188.45 AS-BUILT 6,001 S.F. TOW=191.83 21.00 3 46 10/18/05 FE=193.28 TW=191.95 FF=193.16 229 ABTW=191.83 GF=191.28 GF=191.16 9'BF=183.39 9'BF=183.27 OPEN SPACE 30'10" 188.0 187.5 56.29 Ç/ € 187.2 186.4 188.0 N53°29'50"W 120.00 38 DATE:

CONSULTING ENGINEERS

& SURVEYORS

173 Sloan Rd.



250 GIBRALTAR ROAD 2nd FLOOR, EAST WING HORSHAM, PA. 19044 TEL: (215) 914-2050 FAX: (215) 293-5489

THOMAS B. HENDRICKS

PROFESSIONAL LAND SURVEYOR PA LICENSE NO. SU-044552 PA

DATE: JOB NO.: FILE NAME: LOT 37 1114 LOT037-1114 9-1-2005 "PLOT PLAN" SCALE: ORDER NO.: 1"=20' PP111400370001 REGENCY @ PROVIDENCE DRAWN: SHEET NO.: UPPER PROVIDENCE TOWNSHIP OF M.P.G. MONTGOMERY COUNTY, PENNSYLVANIA

REV.

REVISED GRADING

CHANGE HOUSE

DESCRIPTION

S.J.C. 12-02-2005

DWN. BY DATE

MRH 10-24-2005

193.0